


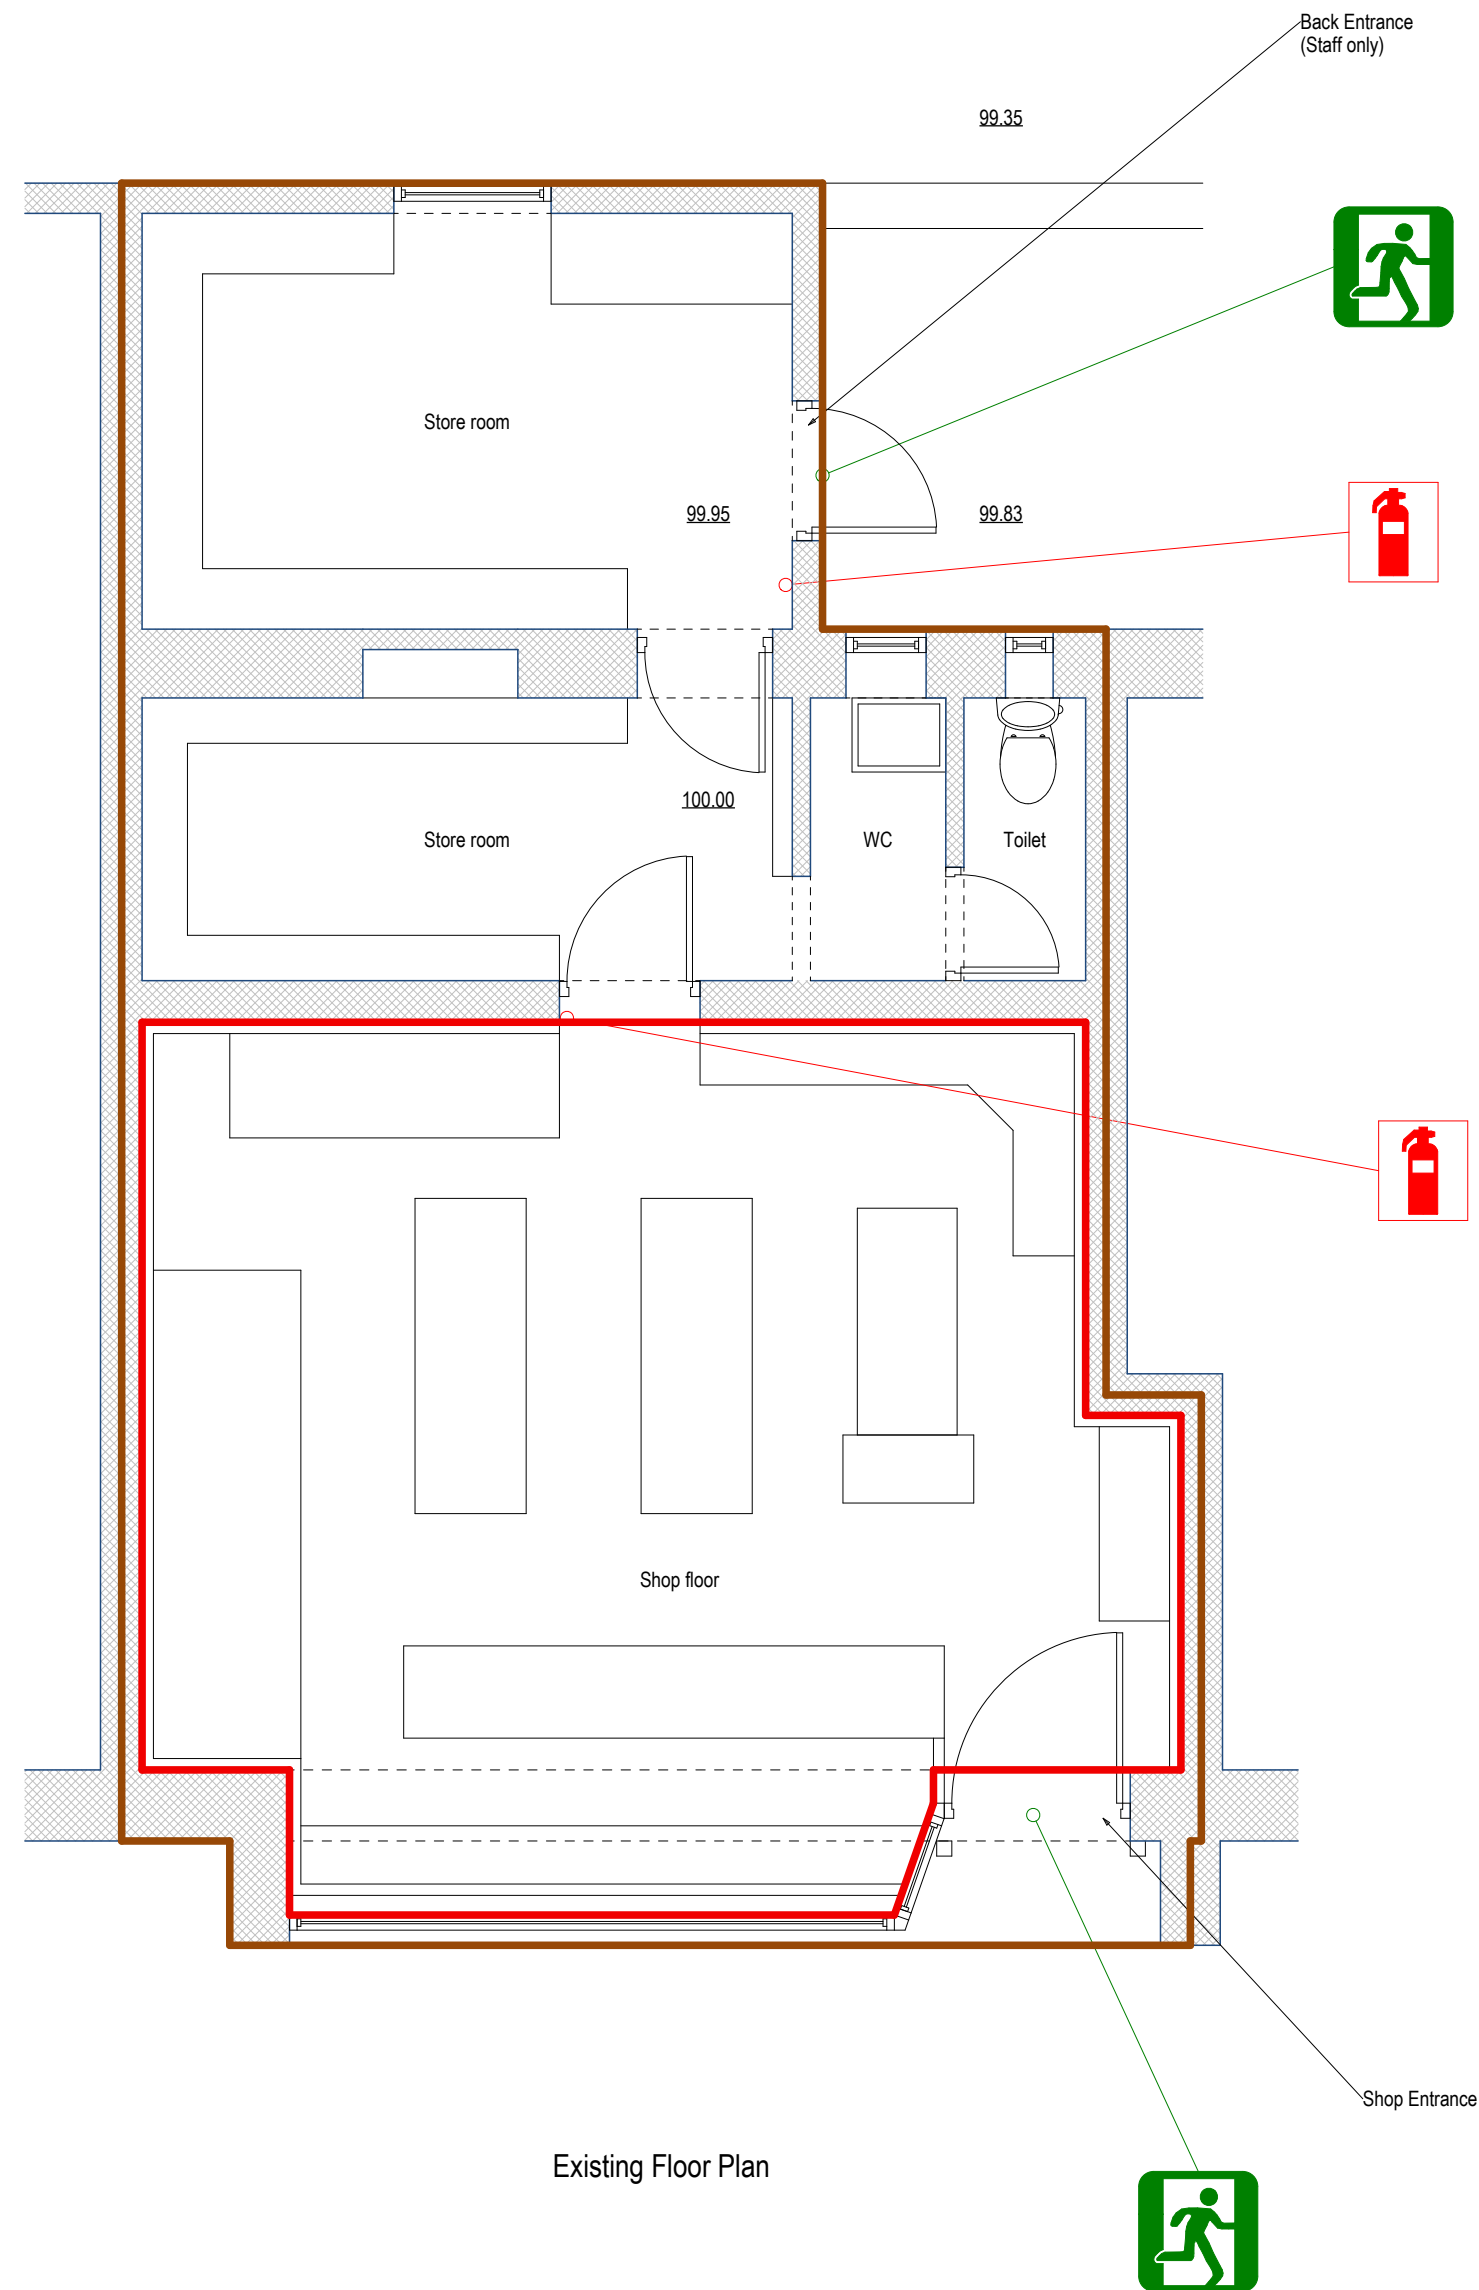

Existing Floor Plan

KEY	
	Fire Extinguisher
	Fire Exit

THIS DRAWING IS COPYRIGHT © A & K ARCHITECTURAL SERVICES and can only be altered, copied or distributed with the written permission of A & K Architectural Services.

All dimensions to be checked on site and are the responsibility of the contractor who should visit the site and make their own assessment, only figured dimensions should be used

All discrepancies must be reported before proceeding

This drawing is to be read in conjunction with any notes, standards and codes of practice

1	04/09/2026	Drawing Introduced	DT
Rev	Date	Notes	By
Project	Floor Plans	Drawing No.	1715/Sht 400/AS BUILT
Client	Mrs Jaison	Drawing Title	Existing Floor Plans
Address	Jino's Convenience Store 133 Callington Rd Saltash PL12 6EB	Scale	1:50
		Date drawn	4th September 2026
		Drawn by	D Turner



A&K ARCHITECTURAL
services

Awenek Studio, 4 Fore Street, St Stephen, PL26 7NN
Tel: 01208 220 214 Email: enquiries@akarchitecturalservices.co.uk